## GENERAL NOTES

1. It shall be the responsibility of the contractor to clear the right of way in accordance with the provisions of law as it affects each utility including irrigation lines and appurtenances and at no cost to the City.
2. Construction shall be in accordance with the City of Riverside Department of Public Works, Standard Drawings, Standard Drawing No. 10 and the Standard Specifications for Public Works Construction, current edition.
3. Quantities shown are for information only and the City of Riverside is not responsible for their accuracy.
4. The private engineer signing these plans is responsible for assuring the accuracy and acceptability of the work hereon. In the event of discrepancies arising during construction, the private engineer shall be responsible for determining an acceptable solution and revising the plans for approval by the City.
5. The contractor shall call in a location request to Underground Service Alert (USA), Phone No. 1-800-422-4133, two working days before digging. No construction permit issued by the Public Work Department involving excavation for underground facilities will be valid unless the applicant has been provided an inquiry identification number by U.S.A.

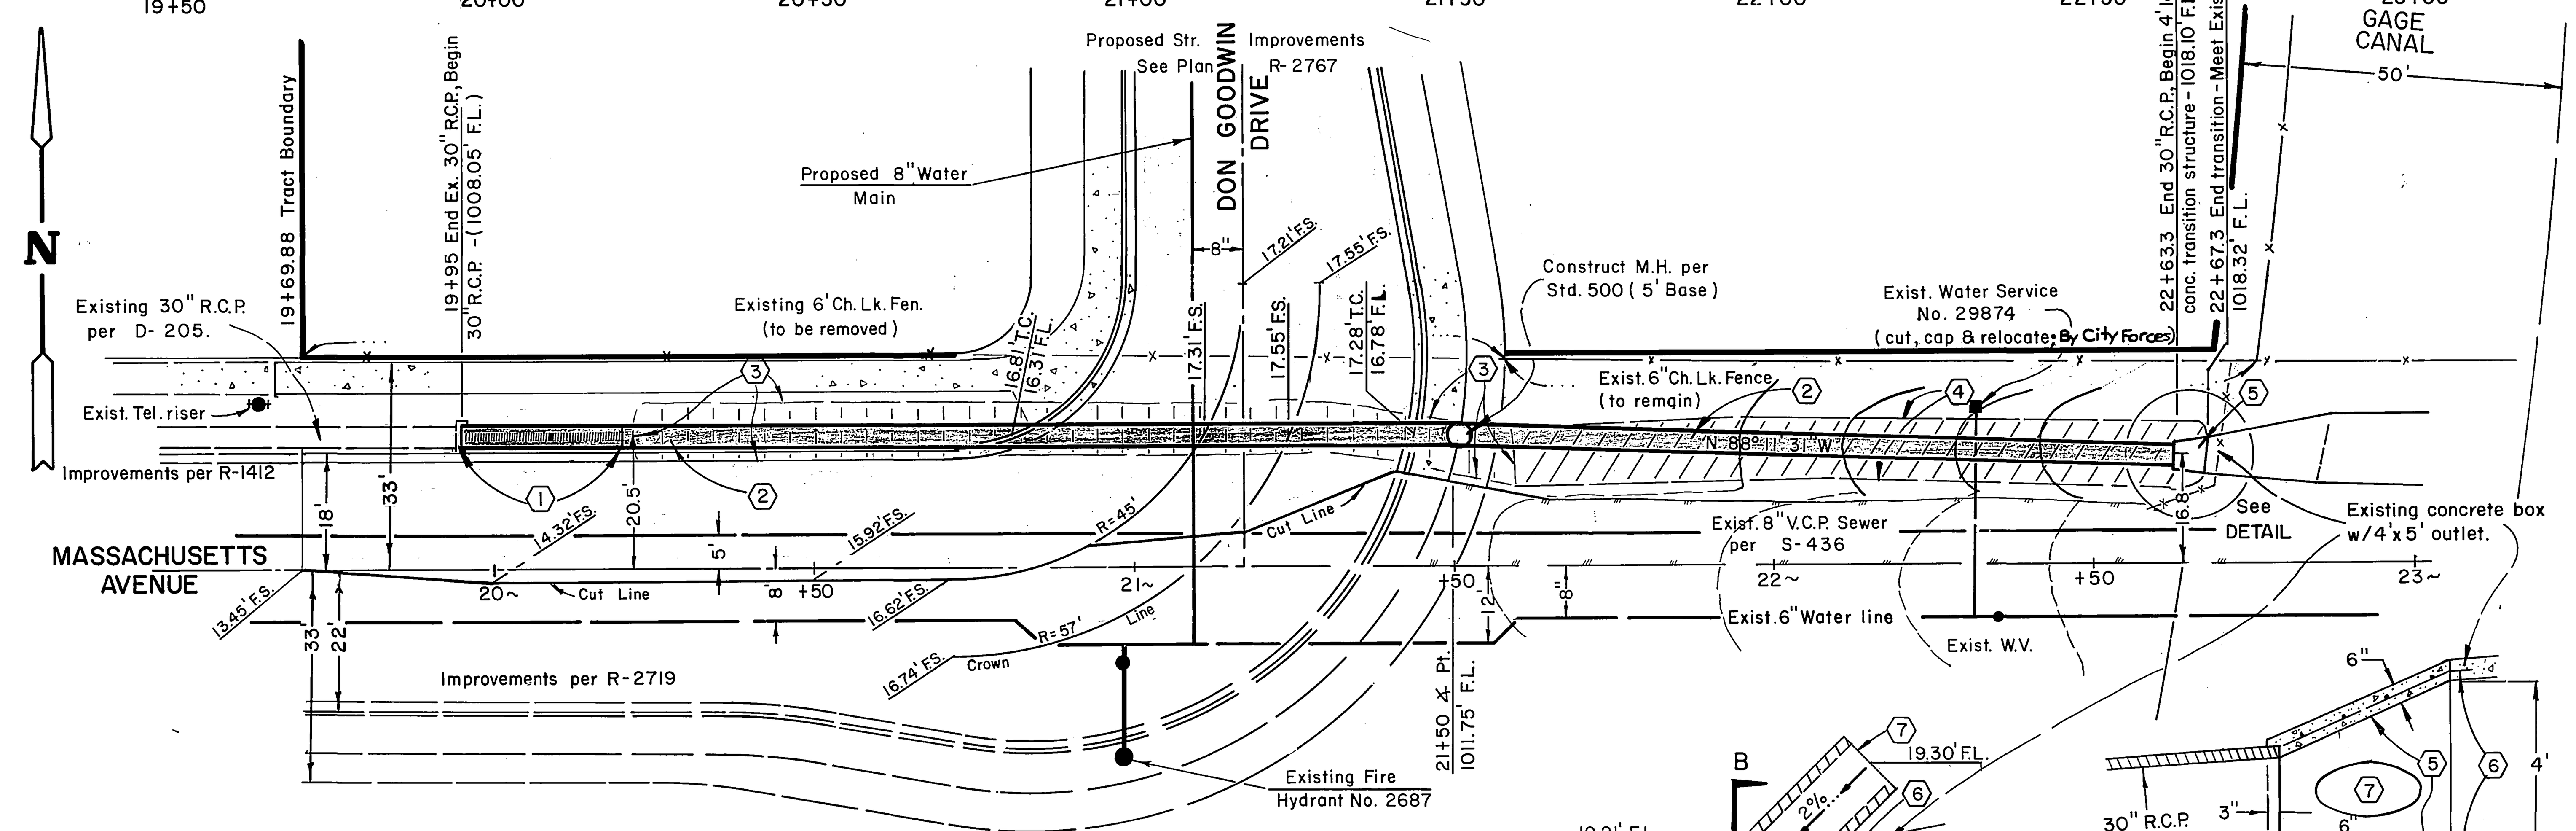


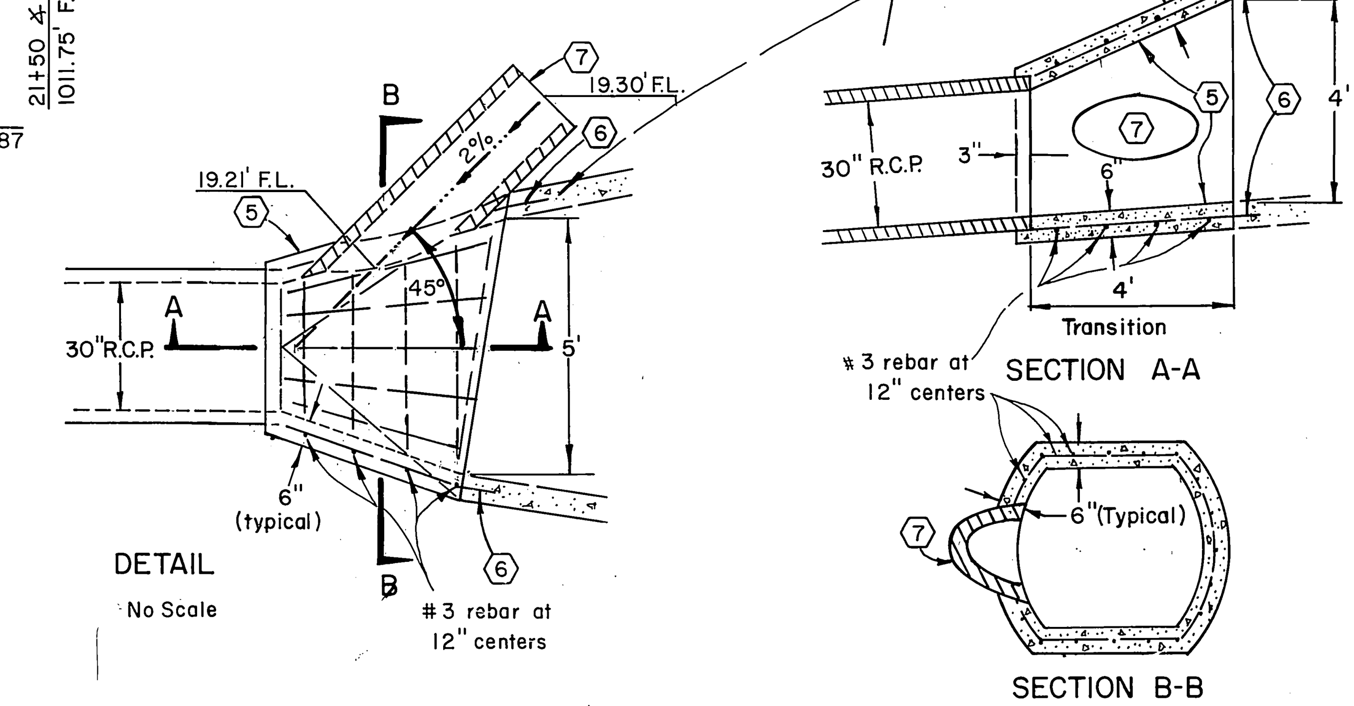


## CONSTRUCTION NOTES

(1) Remove Existing 30" C.M.P. and concrete collar.

(2) Install 268.3 L.F. 30" R.C.P., D=1500.

(3) Remove Existing A.C. lined ditch.

(4) Remove Existing concrete lined ditch.

(5) Construct concrete transition structure per detail, right.

(6) Dowel rebar into existing. Box structure: 4" penetration and fill cavity with expanding grout.

(7) Install 6 L.F. 15" R.C.P., D=2000, at 2% grade. Plug end.

REGISTERED PROFESSIONAL ENGINEER PAUL DIEGES NO. 13234 CIVIL STATE OF CALIFORNIA

*As built 2-11-87

INDEXED D.N.

CITY OF RIVERSIDE
WATER SYSTEM
APPROVED BY:
David V. Garcia 4-14-86
Engineer - Water Date

PERRIS ENGINEERING (714) 657-2822
Paul Dieges - Civil Engineer - R.C.E. 13,234 EXPIRES 3-31-89
1051 Davids Road, Perris, Calif. 92370
APPROVED BY: Paul Dieges 12-23-85
SCALE: Horizontal, 1" = 20'; Vertical, 1" = 2'

BENCH MARK:
Found Standard Brass Disk stamped G1144 1961, at the Highland Grammer School, set vertically in the west wall of a concrete patio, 2 feet above the ground.
ELEVATION = 1077.842'

| MARK | REVISIONS | APPR. | DATE |
|---|---|---|---|
| | | | |

DESIGNED BY: PD DRAWN BY: JT CHECKED BY: GY

CITY OF RIVERSIDE, CALIFORNIA
PUBLIC WORKS DEPARTMENT

| APPROVED BY | BY | DATE |
|---|---|---|
| PRINCIPAL ENGINEER | — | — |
| PARK DEPARTMENT | — | — |
| TRAFFIC DIVISION | — | — |
| CHIEF PUB. WKS. ENGR. | | |
| | | 5/6/86 |

APPROVED BY: William D. Gordon
DIRECTOR OF PUBLIC WORKS
DATE: 5/7/86

STORM DRAIN PLAN AND PROFILE
TRACT NO. 10,852
MASSACHUSETTS AVE.
120' W./O DON GOODWIN DRIVE TO GAGE CANAL
W.O. 85-94 FOR: California Mustang Grp. F.B.

ACCOUNT NO.
DRAWING NO.
D-489
Sheet 1 of 1 Sheets